
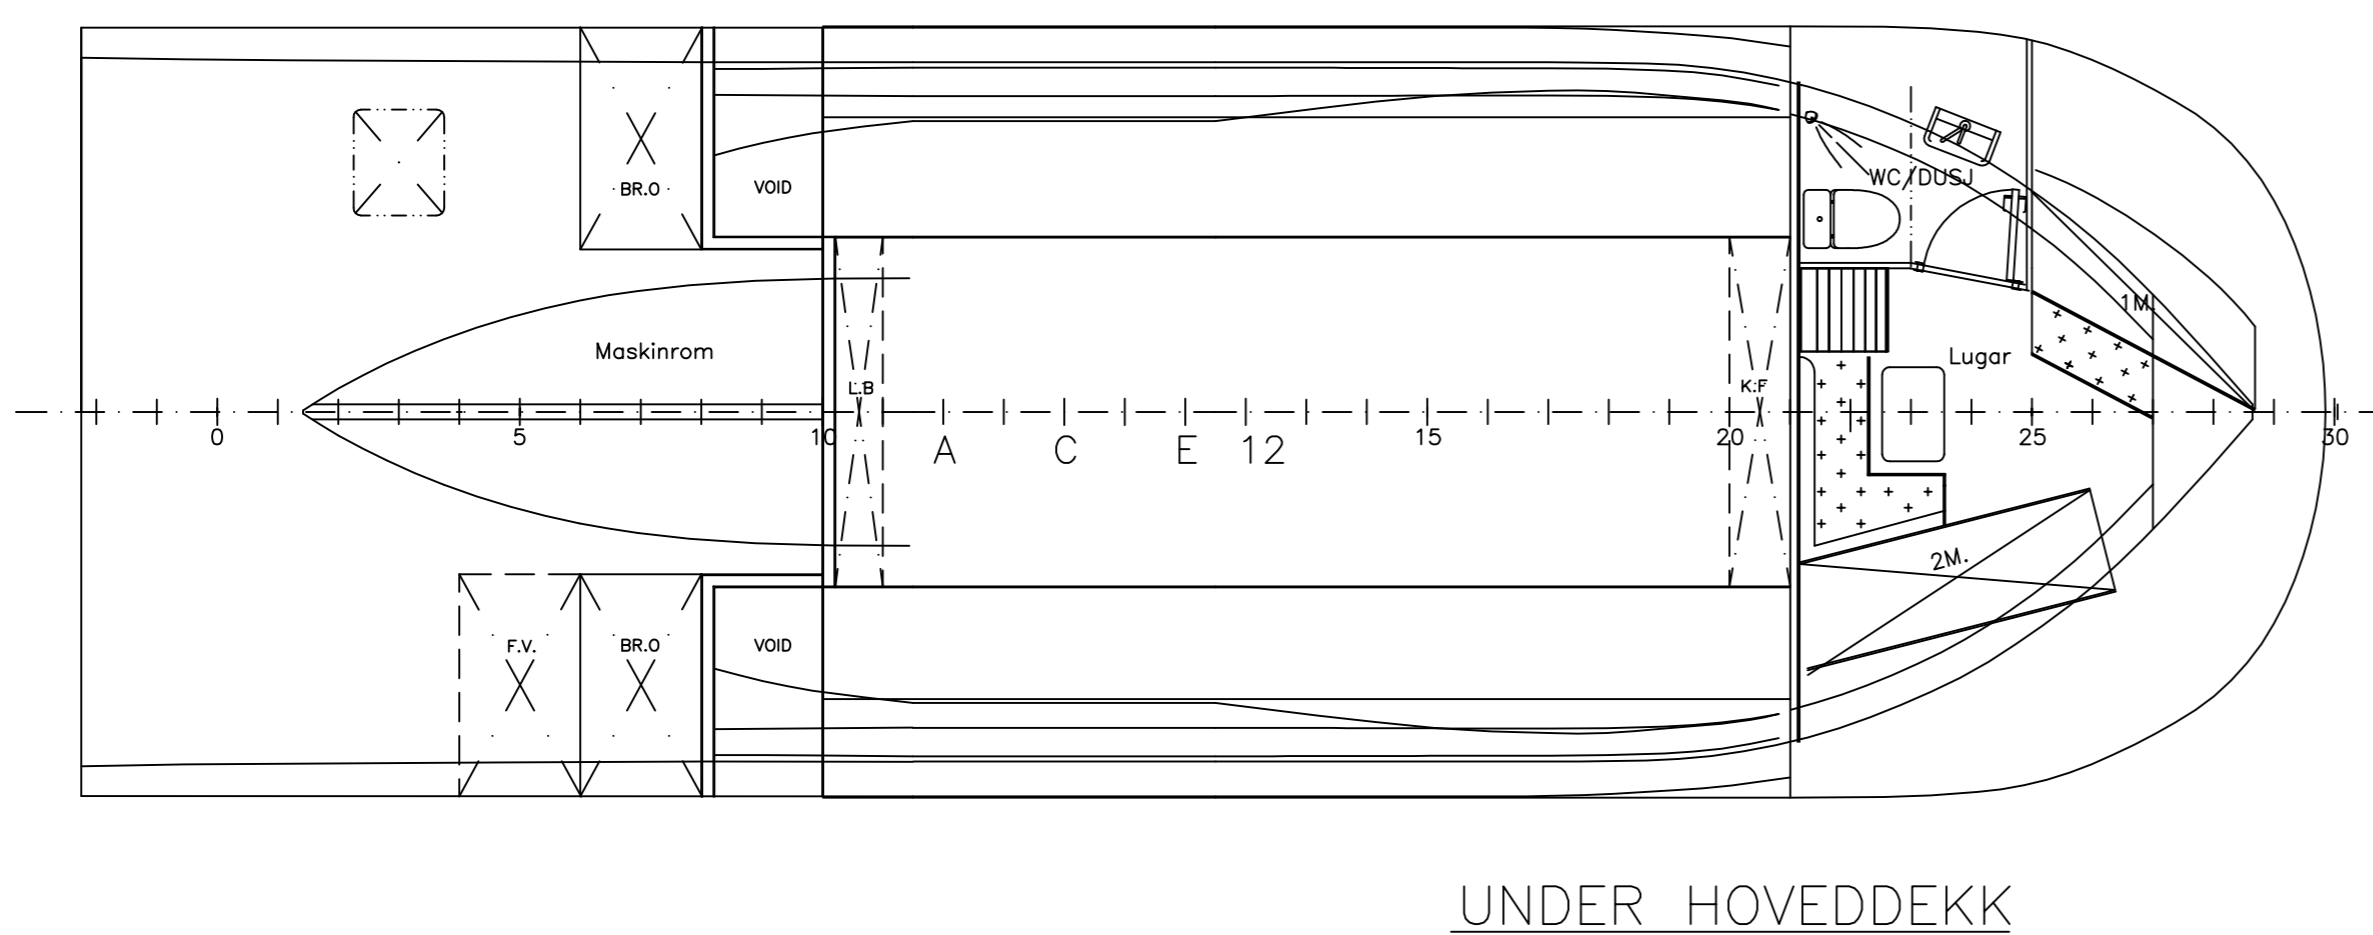
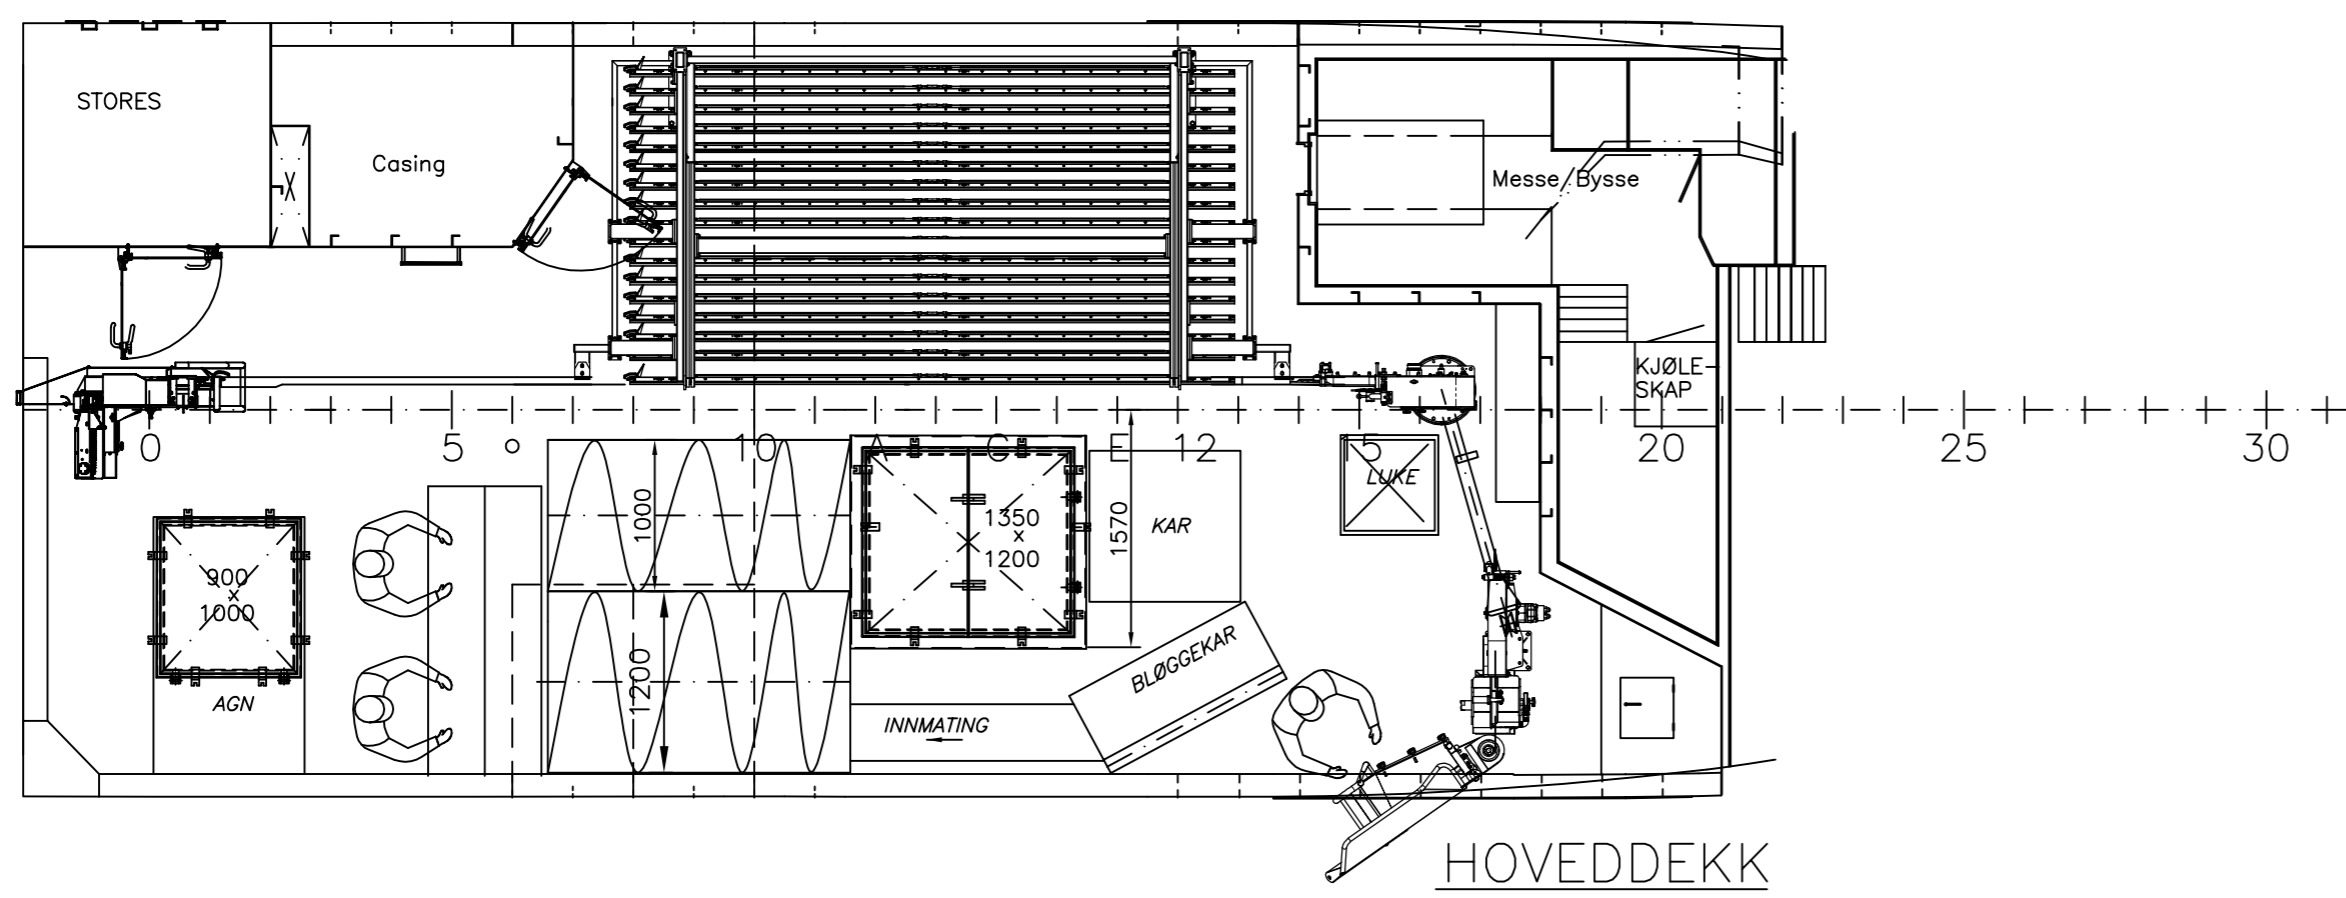
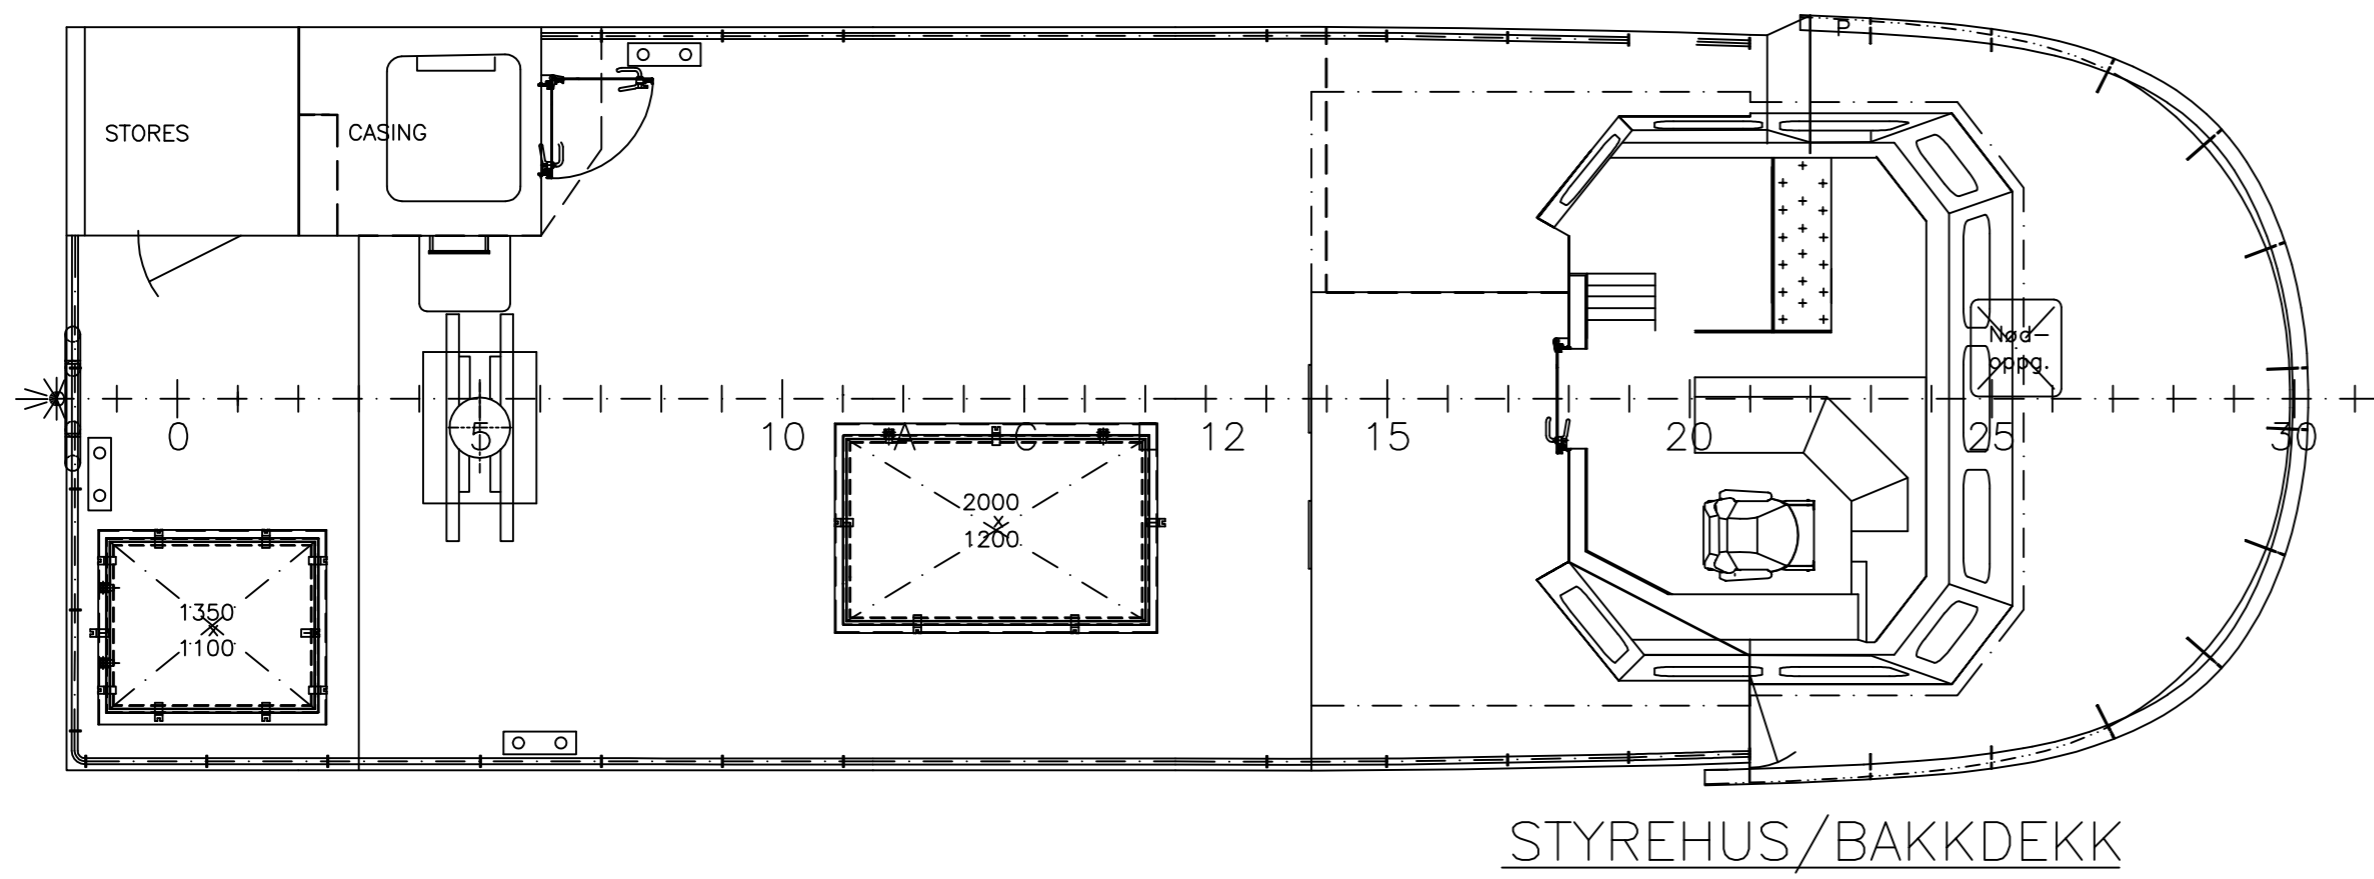
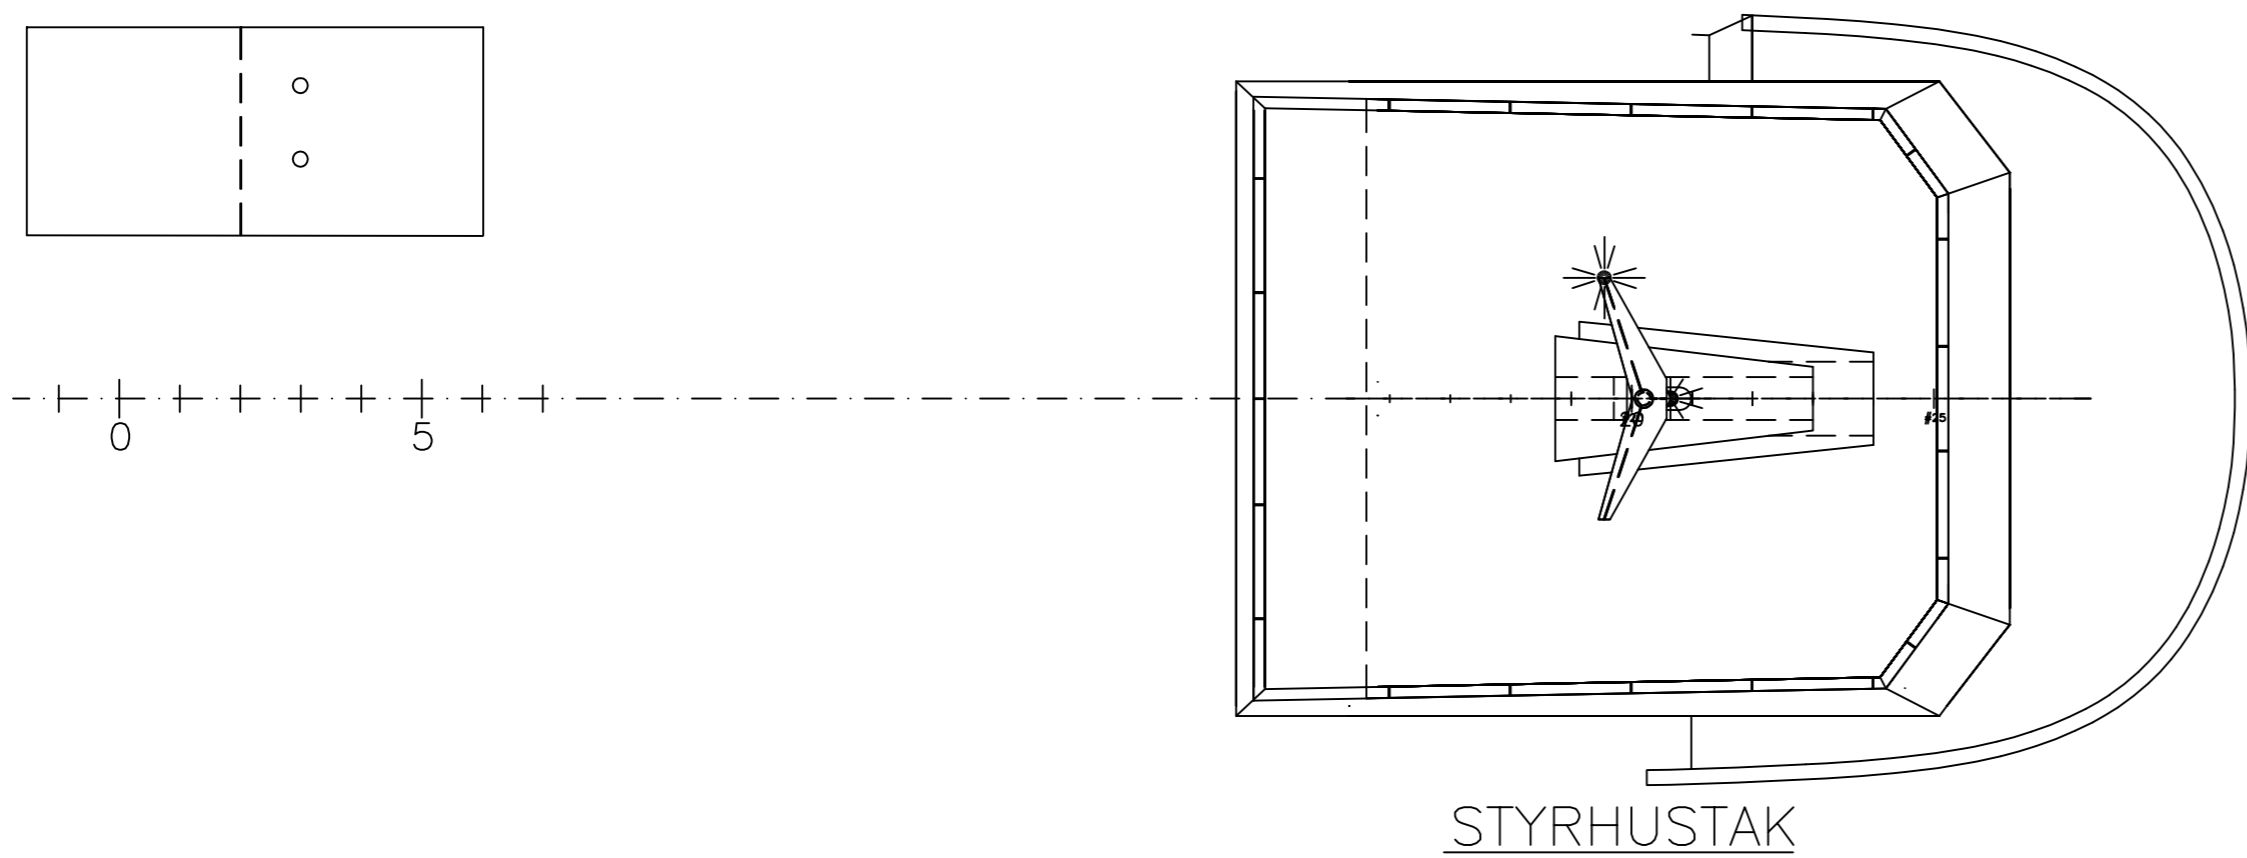


# m/s "ODDEN" - LG 2656

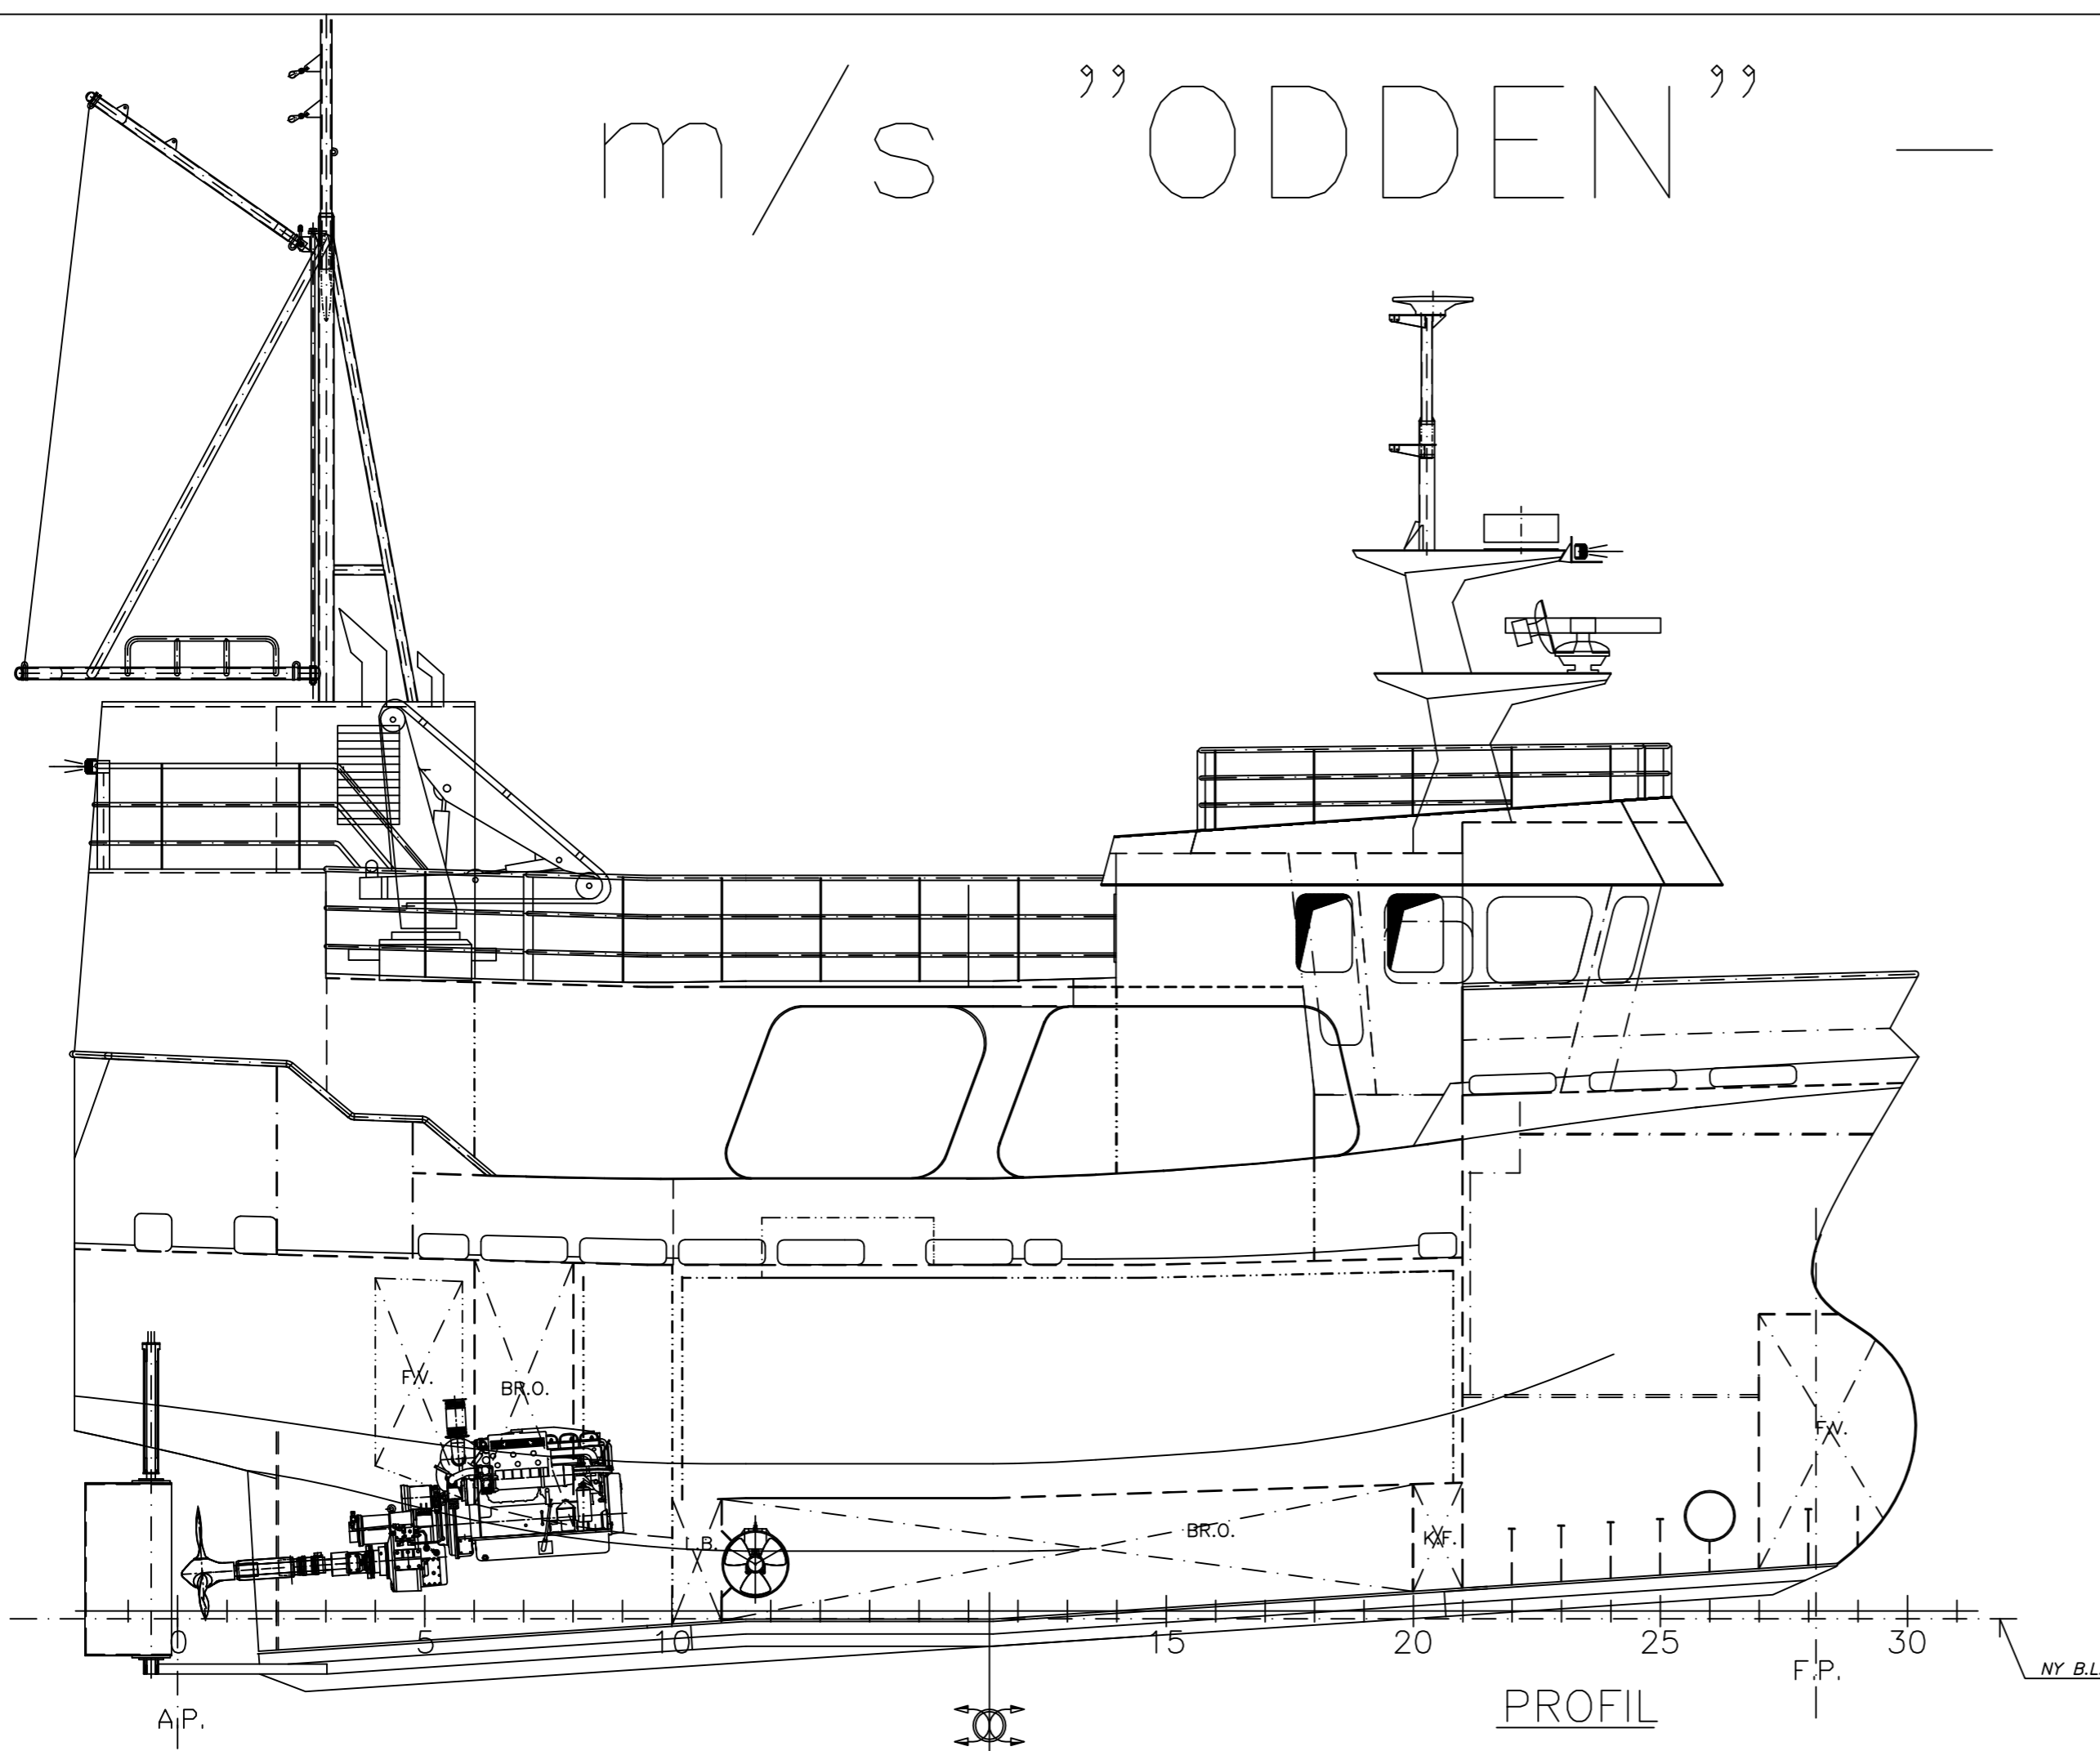

| HOVEDDIMENSJONER    |         | FORLENGET: |  |
|---------------------|---------|------------|--|
| Lengde o.a. ....    | 12,99 m | 14,96 m    |  |
| Lengde p.p. ....    |         | 13,258 m   |  |
| Bredde .....        | 5,13 m  | 5,13 m     |  |
| Dybde riss ca. .... | 2,80 m  | 2,862 m    |  |

|  |          |  |           |          |  |   |        |       |           |      |           |  |  |          |  |
|--|----------|--|-----------|----------|--|---|--------|-------|-----------|------|-----------|--|--|----------|--|
| A5   | 19.06.17 | Korrigert som bygget                                     | A6        | --       | ---  |   |        |       |           |      |           |  |  |          |  |
| A3   | 16.08.16 | INNLAGT REV. D FRA MUSTAD<br>KAP.: 24100 KROK            | A4        | 14.11.16 | KORRIGERT ETTER MØTE MED REDERI<br>10.11.-16                       |   |        |       |           |      |           |  |  |          |  |
| A1   | 11.07.16 | FORLENGET 2,0 M - PARALLELT m/BASIS<br>IGJENDYGGET AKTER | A2        | 02.08.16 | DØR I MASK. CASING FLYTTET.<br>TANK / LUTTEBALE I CASING REDUSERT. |   |        |       |           |      |           |  |  |          |  |
| REV.:  | DATE:    | DESCRIPTION:   | REV.:     | DATE:    | DESCRIPTION:   |   |        |       |           |      |           |  |  |          |  |
| OWNER: KENFISH AS, FLATSET, 6530 AVERØY  |          |  |           |          |  |   |        |       |           |      |           |  |  |          |  |
| CLASS INST. YARD No.: m/s BUAODDEN -LG 2656  |          |  |           |          |  |   |        |       |           |      |           |  |  |          |  |
| <table border="1"> <tr> <td rowspan="3"> <b>GH Marine</b><br/>                     Kristiansund - Norway                 </td> <td>SCALE:</td> <td>DATE:</td> <td>11.07.-16</td> </tr> <tr> <td>1:50</td> <td>DRAWN BY:</td> <td></td> </tr> <tr> <td></td> <td>CONTROL:</td> <td></td> </tr> </table> |          |  |           |          |  | <b>GH Marine</b><br>Kristiansund - Norway | SCALE: | DATE: | 11.07.-16 | 1:50 | DRAWN BY: |  |  | CONTROL: |  |
| <b>GH Marine</b><br>Kristiansund - Norway  | SCALE:   | DATE:  | 11.07.-16 |          |  |   |        |       |           |      |           |  |  |          |  |
|  | 1:50     | DRAWN BY:  |           |          |  |   |        |       |           |      |           |  |  |          |  |
|  |          | CONTROL:   |           |          |  |   |        |       |           |      |           |  |  |          |  |
| TITLE: GENERALARRANGEMENT. GARN - AUTOLINE   |          |  |           |          |  |   |        |       |           |      |           |  |  |          |  |
| REPLACEMENT FOR: DRAWING No.: 010-1-001 REV.No.: A5  |          |  |           |          |  |   |        |       |           |      |           |  |  |          |  |
| CADFILE:   |          |  |           |          |  |   |        |       |           |      |           |  |  |          |  |

THIS DRAWING AND/OR SPECIFICATION IS OR DISCLOSED FOR ANY THIRD PERSON WITHOUT OUR PERMISSION.

OWNER: KENFISH AS, FLATSET, 6530 AVERØY

CLASS INST. YARD No.: m/s BUAODDEN -LG 2656

TECHNICAL AUTHORITY: 16.01.17